

# NOTES

1. INFORMATION ON THESE PLANS HAS BEEN TAKEN FROM:

|           |                   |       |          |
|-----------|-------------------|-------|----------|
| DRAWING'S | GTS-595-DW-PL-002 | REV 2 | AS BUILT |
|           | GTS-595-DW-PL-003 | REV 2 | AS BUILT |
|           | GTS-595-DW-PL-004 | REV 2 | AS BUILT |
|           | GTS-595-DW-PL-005 | REV 2 | AS BUILT |
|           | GTS-595-DW-PL-006 | REV 2 | AS BUILT |
|           | GTS-595-DW-PL-007 | REV 2 | AS BUILT |

PREPARED IN 2007, AND SURVEY CONDUCTED ON THE AS-CONSTRUCTED PIPELINE DATED OCTOBER 2007.

2. HORIZONTAL DATUM MGA 94 ZONE 56.


3. VERTICAL DATUM AHD.

4. H.D.D. (HORIZONTAL DIRECTIONAL DRILLING) DATA SHOWN IS FROM CONTRACTORS BORE LOGS AND WAS NOT DIRECTLY SURVEYED.


5.  DENOTES PIPELINE'S ACT MARKER POSTS.

6.  DENOTES PIPE LOCATION AND ACCOMPANYING MGA CO-ORDINATE.

|                 |       |               |          |                                                                                                                                                                                                                        |                                                                                    |             |                                |                                                                                  |                                                                                                                                |
|-----------------|-------|---------------|----------|------------------------------------------------------------------------------------------------------------------------------------------------------------------------------------------------------------------------|------------------------------------------------------------------------------------|-------------|--------------------------------|----------------------------------------------------------------------------------|--------------------------------------------------------------------------------------------------------------------------------|
| SOFTWARE MARKET | ISSUE | AMENDMENT     | DATE     | LandTeam Australia Pty Ltd<br>A301 26, 260 263 802<br>Wollongong Office<br>5/97 Shellharbour Road<br>Postal: PO Box 353<br>WARILLA NSW 2528<br>p: (02) 4296 7055<br>f: (02) 4297 1163<br>e: wollongong@landteam.com.au |  | A3<br>SHEET | ENERGY AUSTRALIA<br>TALLAWARRA | EASTERN GAS PIPELINE<br>TO TALLAWARRA<br>GAS SUPPLY LINE<br>AS-BUILT INFORMATION | SURVEY DATE: OCT 2007<br>SURVEYED:<br>DRAWN: AJC<br>CHECKED: DAL<br>DRAWING No.<br><b>212195-AS01</b><br>SHEET 1 OF 4 SHEET(S) |
|                 | A     | INITIAL ISSUE | 22/01/20 |                                                                                                                                                                                                                        |                                                                                    |             |                                |                                                                                  |                                                                                                                                |
|                 |       |               |          |                                                                                                                                                                                                                        |                                                                                    |             |                                |                                                                                  |                                                                                                                                |
|                 |       |               |          |                                                                                                                                                                                                                        |                                                                                    |             |                                |                                                                                  |                                                                                                                                |

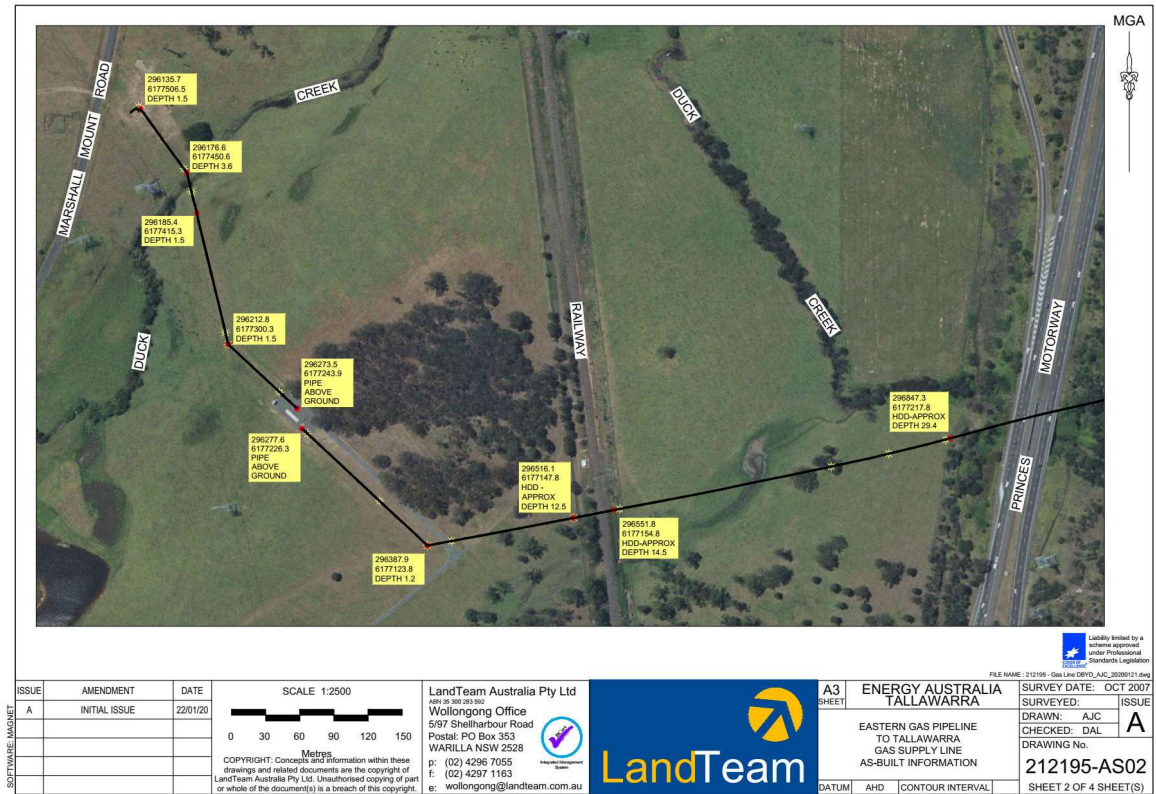

MGA

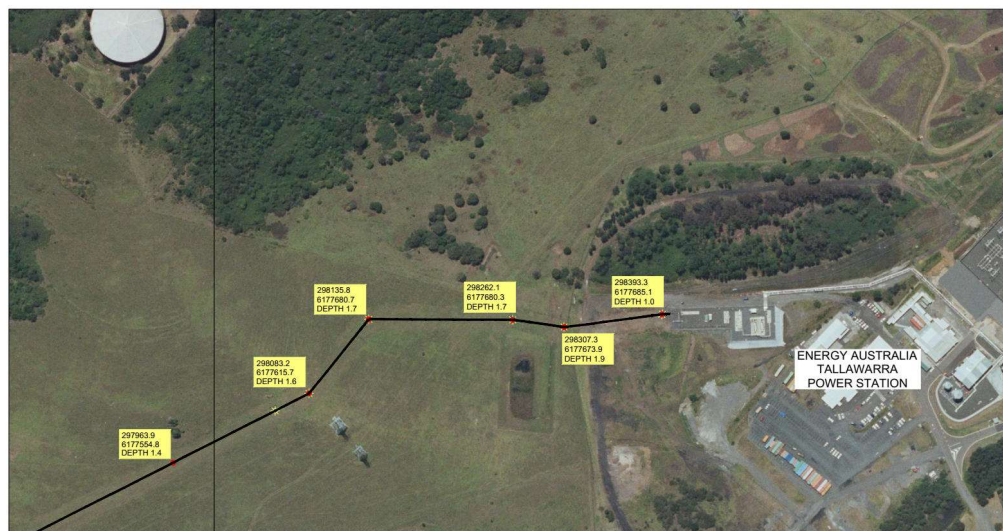

Liability limited by a  
scheme approved  
under Professional  
Standards Legislation

FILE NAME: 212195 - Gas Line DWG01\_AJC\_20200101.dwg

|                  |       |               |          |                                                                                                                                                                                                                                                                      |                                                                                                                                                                                                                                                             |                                                                                                                                                                                   |                                                                                                                                                               |                              |
|------------------|-------|---------------|----------|----------------------------------------------------------------------------------------------------------------------------------------------------------------------------------------------------------------------------------------------------------------------|-------------------------------------------------------------------------------------------------------------------------------------------------------------------------------------------------------------------------------------------------------------|-----------------------------------------------------------------------------------------------------------------------------------------------------------------------------------|---------------------------------------------------------------------------------------------------------------------------------------------------------------|------------------------------|
| SOFTWARE: MAGNET | ISSUE | AMENDMENT     | DATE     | <p>SCALE 1:2500</p> <p>Metres</p> <p>COPYRIGHT: Concessions and information within these drawings and related documents are the copyright of LandTeam Australia Pty Ltd. Unauthorised copying of part or whole of the document(s) is a breach of this copyright.</p> | <p>LandTeam Australia Pty Ltd</p> <p>48/151-151-201-152</p> <p>Wollongong Office</p> <p>5/97 Shellharbour Road</p> <p>Postal: PO Box 353</p> <p>WARILLA NSW 2528</p> <p>p: (02) 4296 7055</p> <p>f: (02) 4297 1163</p> <p>e: wollongong@landteam.com.au</p> | <p>A3 SHEET</p> <p><b>ENERGY AUSTRALIA TALLAWARRA</b></p> <p>EASTERN GAS PIPELINE TO TALLAWARRA GAS SUPPLY LINE</p> <p>AS-BUILT INFORMATION</p> <p>DATUM AHD CONTOUR INTERVAL</p> | <p>SURVEY DATE: OCT 2007</p> <p>SURVEYED:</p> <p>DRAWN: AJC</p> <p>CHECKED: DAL</p> <p>DRAWING No.</p> <p><b>212195-AS04</b></p> <p>SHEET 4 OF 4 SHEET(S)</p> | <p>ISSUE</p> <p><b>A</b></p> |
|                  | A     | INITIAL ISSUE | 22/01/20 |                                                                                                                                                                                                                                                                      |                                                                                                                                                                                                                                                             |                                                                                                                                                                                   |                                                                                                                                                               |                              |
|                  |       |               |          |                                                                                                                                                                                                                                                                      |                                                                                                                                                                                                                                                             |                                                                                                                                                                                   |                                                                                                                                                               |                              |
|                  |       |               |          |                                                                                                                                                                                                                                                                      |                                                                                                                                                                                                                                                             |                                                                                                                                                                                   |                                                                                                                                                               |                              |